

Work Order ID 89115

August-21-12 2:31:01 PM

89115

Page 1

Item ID: D212-664-107TRN

Accept

N900040100

Setup

Start

NS1

Revision ID:

Item Name: Crosstube Turning Detail

Stop

NS2

Start Date: 8/21/12 Start Qty: 1.00

1

Cust Item ID:

Required Date: 9/14/12 Req'd Qty: 1.00

1

Customer:

Reference:

Approvals:

Process Plan: MLJ

Date: 12/08/22 Tooling:

Date:

Run

Start

NR1

QC:

Date:

SPC (Y/N):

Date:

Stop

NR2

Sequence ID/ Work Center ID	Operation Description	Set Up/ Run Hours	Tool ID	Tool #	Plan Code	Accept Qty	Reject Qty	Reject Number	Insp. Stamp
--------------------------------	--------------------------	----------------------	---------	--------	--------------	---------------	---------------	------------------	----------------

Draw Nbr	Revision Nbr
----------	--------------

D212-664-147	Rev B(DE0)
--------------	------------

100

0.00

100

MORI SEIKI CNC LATHE LARGE

Mori Seiki

Mori Seiki CNC Lathe Large

Memo

0.00

1-Fill tube with sand & install plugs DT8534 on both ends as per Folio FA705

2-Turn first side as per Folio FA113

3-Blend transition lines only, **do not sand whole tube**:

FOLIO REV: A

DWG REV: B

*Use mill bastard file, brush file repeatedly with file card.

*Do not use sandpaper coarser than 320 grit.

1 φ KC 12-10-4

110

QC1- Inspect dimensions to dimension sheet

0.00

110

Memo

0.00

QC

Quality Control

1 φ KC 12-10-4

NCR: Yes / No

WORK ORDER NON-CONFORMANCE / UPDATE

DOA: ✓ Date: 12/11/02

QA Closed: ✓ Date: 4

Work Order:	89115			DISPOSITION	Rework Scrap Use-as-is Work Order Update	Skid-tube Machining Thermoforming Large Fab	Crosstube Small Fab Finishing Composite	Water Jet Prod. Eng. Coor. Rec/Store/Packaging Supplier	Engineering Quality Other	
Part No.	D212-664-107TRN									
NCR No.	12-1995									
Root Cause	Date	Step	Qty	Description of work order update or Non-conformance		Initial Chief Eng	Action Description	Sign & Date	Verification	QC Inspector
Doc/Data	12/10/24	100	1	ultrasound over tol. See F.A.I. Sheet.		DAS 12 0.89 12/10/24	Acceptable. min well is above dwg nominal)	DAS 16 0.89 12/10/24	DAS 16 0.89 12/10/24	DAS 16 0.89 12/10/24
Equip/Tooling										
Operator										
Material										
Setup										
Other										
Process										
Supplier										
Training										
Unapproved										
FAULT CATEGORY										
Landing Gear				General						
Bending	Bend	Grain	Ovalized	Pressure/Forced						
Centre Not Concentric to O/S	BOM/Route	Hardware	Over/Under tolerance	Temperature/Cure						
Cracks	Broken/Damaged	Inspection Incomplete	Part Incorrect	Weld						
Crushed/Crimped	Burrs	Instructions Incomplete/Unclear	Part Lost/Missing	Wrong Stock Pulled						
Cuffs	Contamination	Maintenance	Part Moved							
Heat Treat	Countersink	Mislabeled	Positioned Wrong							
Inspection Strip in Tube	Cut Too Short	Misread	Power Loss/Surge							
Ripples in Bend	Drill Holes	Offset								
Torque Waves in Extrusion	Drawing	Out of Calibration								
Turning Sequence	Finish	Out of Sequence								
Wave/Twist in Tube	Folio	Outside Dimensions								

Work Order ID 89115

August-21-12 2:31:02 PM

89115

Page 2

Item ID: D212-664-107TRN

Accept

N900040100

Setup Start

NS1

Revision ID:

Item Name: Crosstube Turning Detail

Stop

NS2

Start Date: 8/21/12 Start Qty: 1.00

1

Cust Item ID:

Required Date: 9/14/12 Req'd Qty: 1.00

1

Customer:

Reference:

Approvals: Process Plan:

Date:

Tooling:

Date:

Run Start

NR1

QC:

Date:

SPC (Y/N):

Date:

Stop

NR2

Sequence ID/
Work Center ID

Operation
Description

Set Up/
Run Hours

Tool ID

Tool #

Plan
Code

Accept
Qty

Reject
Qty

Reject
Number

Insp.
Stamp

120

120

Mori Seiki

Mori Seiki CNC Lathe Large

0.00

MORI SEIKI CNC LATHE LARGE

Memo

0.00

1-Turn second side as per Folio FA705

2-Blend transition lines only. **do not sand whole tube**:
*Use mill bastard file, brush file repeatedly with file card.

*Do not use sandpaper coarser than 320 grit.

FOLIO REV: A

DWG REV: B

3- Remove plugs and sand

130

130

QC

Quality Control

QC1- Inspect dimensions to dimension sheet

0.00

Memo

0.00

1 φ KC 12-10-5

1 φ KC 12-10-5

NCR: Yes / No

DQA: _____ Date: _____

WORK ORDER NON-CONFORMANCE / UPDATE

QA Closed: _____ Date: _____

Work Order: _____			DISPOSITION		AGAINST DEPARTMENT/PROCESS					
			Rework <input type="checkbox"/>	Skid-tube <input type="checkbox"/>	Crosstube <input type="checkbox"/>	Water Jet <input type="checkbox"/>	Engineering <input type="checkbox"/>			
			Scrap <input type="checkbox"/>	Machining <input type="checkbox"/>	Small Fab <input type="checkbox"/>	Prod. Eng. Coor. <input type="checkbox"/>	Quality <input type="checkbox"/>			
			Use-as-is <input type="checkbox"/>	Thermoforming <input type="checkbox"/>	Finishing <input type="checkbox"/>	Rec/Store/Packaging <input type="checkbox"/>	Other <input type="checkbox"/>			
			Work Order Update <input type="checkbox"/>	Large Fab <input type="checkbox"/>	Composite <input type="checkbox"/>	Supplier <input type="checkbox"/>				
Root Cause	Date	Step	Qty	Description of work order update or Non-conformance	Initial Chief Eng	Action Description	Sign & Date	Verification	QC Inspector	
Doc/Data										
Equip/Tooling										
Operator										
Material										
Setup										
Other										
Process										
Supplier										
Training										
Unapproved										
FAULT CATEGORY										
Landing Gear <input type="checkbox"/> Bending <input type="checkbox"/> Centre Not Concentric to O/S <input type="checkbox"/> Cracks <input type="checkbox"/> Crushed/Crimped. <input type="checkbox"/> Cuffs <input type="checkbox"/> Heat Treat <input type="checkbox"/> Inspection Strip in Tube <input type="checkbox"/> Ripples in Bend <input type="checkbox"/> Torque Waves in Extrusion <input type="checkbox"/> Turning Sequence <input type="checkbox"/> Wave/Twist in Tube				General <input type="checkbox"/> Bend <input type="checkbox"/> BOM/Route <input type="checkbox"/> Broken/Damaged <input type="checkbox"/> Burrs <input type="checkbox"/> Contamination <input type="checkbox"/> Countersink <input type="checkbox"/> Cut Too Short <input type="checkbox"/> Drill Holes <input type="checkbox"/> Drawing <input type="checkbox"/> Finish <input type="checkbox"/> Folio <input type="checkbox"/> Grain <input type="checkbox"/> Hardware <input type="checkbox"/> Inspection Incomplete <input type="checkbox"/> Instructions Incomplete/Unclear <input type="checkbox"/> Maintenance <input type="checkbox"/> Mislabeled <input type="checkbox"/> Misread <input type="checkbox"/> Offset <input type="checkbox"/> Out of Calibration <input type="checkbox"/> Out of Sequence <input type="checkbox"/> Outside Dimensions						
				<input type="checkbox"/> Ovalized <input type="checkbox"/> Over/Under tolerance <input type="checkbox"/> Part Incorrect <input type="checkbox"/> Part Lost/Missing <input type="checkbox"/> Part Moved <input type="checkbox"/> Positioned Wrong <input type="checkbox"/> Power Loss/Surge <input type="checkbox"/> Other						

Work Order ID 89115

89115

Page 3

August-21-12 2:31:02 PM

Item ID: D212-664-107TRN

Accept

N900040100

Setup

Start

NS1

Revision ID:

Item Name: Crosstube Turning Detail

Stop

NS2

Start Date: 8/21/12 Start Qty: 1.00

1

Cust Item ID:

Required Date: 9/14/12 Req'd Qty: 1.00

1

Customer:

Reference:

Approvals: Process Plan:

Date:

Tooling:

Date:

Run

Start

NR1

QC:

Date:

SPC (Y/N):

Date:

Stop

NR2

Sequence ID/
Work Center ID

Operation
Description

Set Up/
Run Hours

Tool ID

Tool #

Plan
Code

Accept
Qty

Reject
Qty

Reject
Number

Insp.
Stamp

140

QC8- Inspect parts - second check

0.00

140

QC

Quality Control

JW 12-10-26

145

145

Crosstubes

Crosstubes

Memo

0.00

Memo

0.00

GRIND ONLY TRANSITION LINES SMOOTH LONGITUDE WAY.

JW 12-10-26

150

150

HandFXtube

Hand Finishing Crosstubes

0.00

Memo

0.00

I- PRESSURE WASH X-TUBE INSIDE AND OUT

2- ACID ETCH X-TUBE INSIDE AND OUT. USE RED SCOTCH BRITE

Ron 12-10-29

NCR: Yes / No

DQA: Date:

WORK ORDER NON-CONFORMANCE / UPDATE

QA Closed: Date:

Work Order: _____			DISPOSITION			AGAINST DEPARTMENT/PROCESS					
			Rework <input type="checkbox"/> Scrap <input type="checkbox"/> Use-as-is <input type="checkbox"/> Work Order Update <input type="checkbox"/>	Skid-tube <input type="checkbox"/> Machining <input type="checkbox"/> Thermoforming <input type="checkbox"/> Large Fab <input type="checkbox"/>	Crosstube <input type="checkbox"/> Small Fab <input type="checkbox"/> Finishing <input type="checkbox"/> Composite <input type="checkbox"/>	Water Jet <input type="checkbox"/> Prod. Eng. Coor. <input type="checkbox"/> Rec/Store/Packaging <input type="checkbox"/> Supplier <input type="checkbox"/>	Engineering <input type="checkbox"/> Quality <input type="checkbox"/> Other <input type="checkbox"/>				
Part No. _____											
NCR No. _____											
Root Cause	Date	Step	Qty	Description of work order update or Non-conformance	Initial Chief Eng	Action Description	Sign & Date	Verification	QC Inspector		
Doc/Data											
Equip/Tooling											
Operator											
Material											
Setup											
Other											
Process											
Supplier											
Training											
Unapproved											
FAULT CATEGORY											
Landing Gear				General							
				Bending <input type="checkbox"/> Centre Not Concentric to O/S <input type="checkbox"/> Cracks <input type="checkbox"/> Crushed/Crimped <input type="checkbox"/> Cuffs <input type="checkbox"/> Heat Treat <input type="checkbox"/> Inspection Strip in Tube <input type="checkbox"/> Ripples in Bend <input type="checkbox"/> Torque Waves in Extrusion <input type="checkbox"/> Turning Sequence <input type="checkbox"/> Wave/Twist in Tube <input type="checkbox"/>	Grain <input type="checkbox"/> Hardware <input type="checkbox"/> Inspection Incomplete <input type="checkbox"/> Instructions Incomplete/Unclear <input type="checkbox"/> Maintenance <input type="checkbox"/> Mislabelled <input type="checkbox"/> Misread <input type="checkbox"/> Offset <input type="checkbox"/> Out of Calibration <input type="checkbox"/> Out of Sequence <input type="checkbox"/> Outside Dimensions <input type="checkbox"/>	Ovalized <input type="checkbox"/> Over/Under tolerance <input type="checkbox"/> Part Incorrect <input type="checkbox"/> Part Lost/Missing <input type="checkbox"/> Part Moved <input type="checkbox"/> Positioned Wrong <input type="checkbox"/> Power Loss/Surge <input type="checkbox"/>	Pressure/Forced <input type="checkbox"/> Temperature/Cure <input type="checkbox"/> Weld <input type="checkbox"/> Wrong Stock Pulled <input type="checkbox"/> Other <input type="checkbox"/>				

NCR: Yes / No

WORK ORDER NON-CONFORMANCE / UPDATE

DQA: _____ Date: _____

QA Closed: _____ Date: _____

Work Order: _____		DISPOSITION			AGAINST DEPARTMENT/PROCESS								
Part No. _____		Rework <input type="checkbox"/>	Scrap <input type="checkbox"/>	Use-as-is <input type="checkbox"/>	Skid-tube <input type="checkbox"/>	Crosstube <input type="checkbox"/>	Water Jet <input type="checkbox"/>	Engineering <input type="checkbox"/>					
NCR No. _____		Work Order Update <input type="checkbox"/>	Machining <input type="checkbox"/>	Thermoforming <input type="checkbox"/>	Small Fab <input type="checkbox"/>	Prod. Eng. Coor. <input type="checkbox"/>	Quality <input type="checkbox"/>						
			Large Fab <input type="checkbox"/>	Finishing <input type="checkbox"/>	Composite <input type="checkbox"/>	Rec/Store/Packaging <input type="checkbox"/>	Other <input type="checkbox"/>						
Root Cause	Date	Step	Qty	Description of work order update or Non-conformance	Initial Chief Eng	Action Description	Sign & Date	Verification	QC Inspector				
Doc/Data													
Equip/Tooling													
Operator													
Material													
Setup													
Other													
Process													
Supplier													
Training													
Unapproved													
FAULT CATEGORY													
Landing Gear <input type="checkbox"/> Bending <input type="checkbox"/> Centre Not Concentric to O/S <input type="checkbox"/> Cracks <input type="checkbox"/> Crushed/Crimped. <input type="checkbox"/> Cuffs <input type="checkbox"/> Heat Treat <input type="checkbox"/> Inspection Strip in Tube <input type="checkbox"/> Ripples in Bend <input type="checkbox"/> Torque Waves in Extrusion <input type="checkbox"/> Turning Sequence <input type="checkbox"/> Wave/Twist in Tube				General <input type="checkbox"/> Bend <input type="checkbox"/> BOM/Route <input type="checkbox"/> Broken/Damaged <input type="checkbox"/> Burrs <input type="checkbox"/> Contamination <input type="checkbox"/> Countersink <input type="checkbox"/> Cut Too Short <input type="checkbox"/> Drill Holes <input type="checkbox"/> Drawing <input type="checkbox"/> Finish <input type="checkbox"/> Folio				<input type="checkbox"/> Grain <input type="checkbox"/> Hardware <input type="checkbox"/> Inspection Incomplete <input type="checkbox"/> Instructions Incomplete/Unclear <input type="checkbox"/> Maintenance <input type="checkbox"/> Mislabeled <input type="checkbox"/> Misread <input type="checkbox"/> Offset <input type="checkbox"/> Out of Calibration <input type="checkbox"/> Out of Sequence <input type="checkbox"/> Outside Dimensions		<input type="checkbox"/> Ovalized <input type="checkbox"/> Over/Under tolerance <input type="checkbox"/> Part Incorrect <input type="checkbox"/> Part Lost/Missing <input type="checkbox"/> Part Moved <input type="checkbox"/> Positioned Wrong <input type="checkbox"/> Power Loss/Surge		<input type="checkbox"/> Pressure/Forced <input type="checkbox"/> Temperature/Cure <input type="checkbox"/> Weld <input type="checkbox"/> Wrong Stock Pulled	
												<input type="checkbox"/> Other	


DART AEROSPACE LTD	Work Order:	89115
Description: Crosstube Assembly (205/212/412 Low Fwd)	Part Number:	D212-664-147
Inspection Dwg: D212-664-147 Rev: B		Page 1 of 2

FIRST ARTICLE INSPECTION CHECKLIST

Inspection Sheet Drawing Dimension	Tolerance	Actual Dimension	Accept	Reject	Method of Inspection	Comments
SIDE A	0.313	+/-0.010			U.S.	1005928
	2.360	+0.005/-0.000	2.365	/	VERN	CNC -08
	2.360	+0.005/-0.000	2.365	/		
	2.366	+0.005/-0.000	2.368	/		
	2.473	+0.005/-0.000	2.476	/		
	2.573	+0.005/-0.000	2.573	/		
	2.673	+0.005/-0.000	2.678	/		
	2.750	+0.005/-0.000	2.750	/		
	2.750	+0.005/-0.000	2.750	/		
SIDE B	0.313	+/-0.010			U.S.	1005928
	2.360	+0.005/-0.000	2.365	/	CAV-VERN	CNC -08.
	2.360	+0.005/-0.000	2.365	/		
	2.366	+0.005/-0.000	2.368	/		
	2.473	+0.005/-0.000	2.476	/		
	2.573	+0.005/-0.000	2.575	/		
	2.673	+0.005/-0.000	2.678	/		
	2.750	+0.005/-0.000	2.750	/		
	2.750	+0.005/-0.000	2.750	/		
	0.126.528	+/-0.020	126.528	/	TAPE	LG. 22

DART AEROSPACE LTD	Work Order:	89114
Description: Crosstube Assembly (205/212/412 Low Fwd)	Part Number:	D212-664-147
Inspection Dwg: D212-664-147 Rev: B		Page 2 of 2

WALL THICKNESS MEASUREMENT

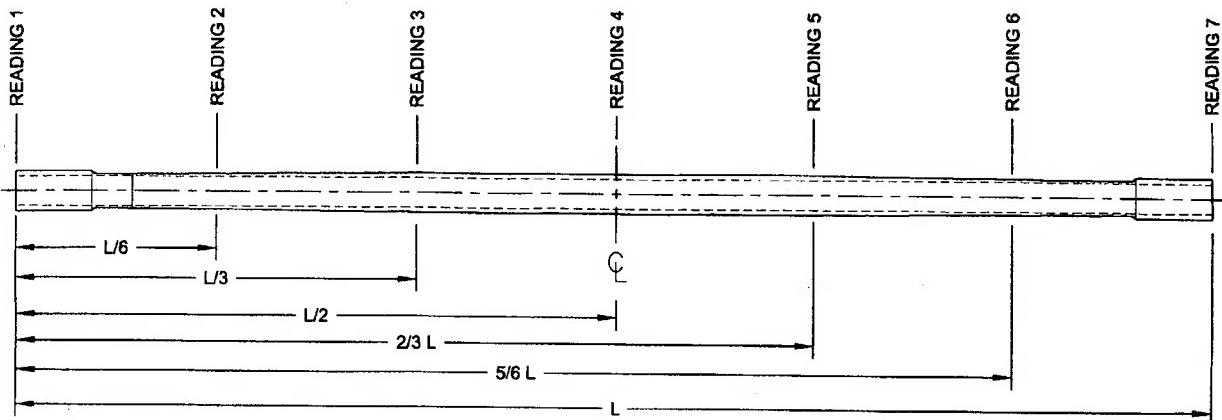

Location	WALL THICKNESS MEASUREMENT (IN)				Deviation Δw (max-min)	TOLERANCE
	w1	w2	w3	w4		
READING 1 L= 0"	.119	.125	.142	.141	.028	
READING 2 L= 14	.119	.125	.155	.146	.046	
READING 3 L= 30	.261	.217	.250	.237	.049	$\rightarrow \Delta w = 0.210$ nominal
READING 4 L= 63	.322	.322	.329	.330	.008	0.048"
READING 5 L= 30	.219	.233	.226	.212	.021	
READING 6 L= 14	.123	.146	.140	.125	.017	
READING 7 L=cuff	.119	.126	.136	.128	.017	


Calibration Result

Actual Block Thickness: _____

Sitescan 250 Measured Thickness: _____

Measured by:	<i>M.M.</i>	Audited by:	<i>JW</i>	Prototype Approval:	N/A
Date:	12/10/06	Date:	12-10-26	Date:	N/A

Rev	Date	Change	Revised by	Approved
A	08.11.07	New Issue (P/O D212-664-107)	KJ/EC	
B	10.02.02	Dimension 126.528 was 126.53	KJ	
C	12.06.04	Wall thickness form added	KJ	<i>MM</i>

 

B

Item	Qty -147	Qty -147B	Part Number	Description
1	X		D212-664-147	CROSSTUBE ASSEMBLY (205/212/412 LOW FWD)
2	X		D212-664-147B	CROSSTUBE ASSEMBLY (214 LOW FWD)
3	1	1	D6019-128	CROSSTUBE
4	2	2	D2893-1	SUPPORT
5	4	4	D3595-063-450	RUBBER CUSHION
6	2	2	D3659-1	CUFF
7	4	4	MS21920-25	CLAMP (OR MS21920-26)
8	44	44	CR3212-4-06	RIVET (OR M7885/3-4-06)
9	A/R	A/R	MAGNOBOND 6398	ROCKWELL SPECIFICATION RBO-120-023 ADHESIVE (TEXTRON/BELL SPEC. 299-947-100, TYPE II, CLASS 2 ADHESIVE)
10	A/R	A/R	SIKAFLEX-241/-291	SEALANT (OR PROSEAL 890 OR MIL-S-8802 CLASS B2 SEALANT)

GENERAL NOTES:

- 1) MATERIAL MANUFACTURED FROM D6019-128
FINISHED LENGTH = 126.528±0.020 (BEFORE BENDING/TRIMMING)
- 2) FINISH: CHEMICAL CONVERSION COAT PER DART QSI 005 4.1
PRIME INSIDE AND OUTSIDE PER DART QSI 005 4.2
PAINT OUTSIDE PER DART QSI 005 4.2
- 3) TOLERANCES ARE PER DART QSI 018 UNLESS OTHERWISE NOTED
- 4) UNITS: INCHES UNLESS OTHERWISE NOTED.
- 5) BREAK SHARP EDGES, 0.005 TO 0.010 MAX
- 6) IDENTIFICATION: SCRIBE DART PART NUMBER "D212-664-XXX" AND BATCH NUMBER ON INSIDE OF CUFF USING VIBRATING STYLUS.
- 7) WEIGHT: D212-664-147 = 24.2 lbs (PER IIN-D212-664)
D212-664-147B = 24.2 lbs (PER IIN-D212-664)
- 8) PART IS SYMMETRIC ABOUT CENTERLINE.
- 9) WHEN MACHINING TAPER, RUN CUTTER OFF PART. BLEND OUT EDGE LONGITUDINALLY. TRANSITION SHOULD BE SMOOTH.
- 10) BEND PROGRESSIVELY WITH A MINIMUM OF 8 PASSES. MAXIMUM TUBE FLATTENING DUE TO BENDING IS 6% BASED ON O.D. EXCEPT UP TO 10% IS ALLOWED IN AREA NOTED
- 11) LIQUID PENETRANT INSPECT OUTSIDE SURFACE OF CROSSTUBE PER QSI 038
- 12) INSTALL D2893-1 SUPPORT USING 0.03" TO 0.06" THICK LAYER OF MAGNOBOND 6398 TO THE SURFACE OF D2893-1 THAT WILL BE IN CONTACT WITH THE CROSSTUBE PER QSI 015. LET CURE FOR 12 HOURS AFTER INSTALLATION AND PRIOR TO PACKAGING.
- 13) INSTALL MS21920-25 CLAMPS (OR -26) WITH D3595-063-450 RUBBER CUSHIONS TO SECURE THE D2893-1 SUPPORT ON TOP SIDE OF THE CROSSTUBE. ENSURE CLAMPS ARE OPPOSITE OF CROSSTUBE SUPPORT.
- 14) EXTREME CARE MUST BE TAKEN TO PROTECT THE OUTSIDE SURFACE OF THE TUBE. THE OUTSIDE SURFACE MUST BE SMOOTH AND FREE FROM SURFACE DEFECTS SUCH AS SCRATCHES, NICKS, OR DENTS. DEFECTS UP TO 0.005" MAY BE BLENDED OUT LONGITUDINALLY. CIRCUMFERENTIAL GRIND MARKS ARE UNACCEPTABLE.
- 15) TORQUE CLAMPS 80 TO 100 IN-LB. ENSURE AT LEAST 15 THREADS SHOWING IN SAFETY AND THAT NUT HAS NOT BOTTOMED-OUT AFTER TORQUING
- 16) INSTALL D3659-1 CUFF AFTER CHEMICAL CONVERSION COAT BUT BEFORE PAINT, WITH A LAYER OF SIKAFLEX-241/-291 OR PROSEAL 890 OR MIL-S-8802 CLASS B2 SEALANT BETWEEN CUFF AND CROSSTUBE. SEAL EDGE OF CUFF TO ENSURE NO GAPS.
- 17) TOUCH-UP HOLES WITH CHEMICAL CONVERSION COAT.

SHOP COPY

RETURN TO

ENGINEERING

UNCONTROLLED COPY

SUBJECT TO AMENDMENT

WITHOUT NOTICE

WORK ORDER

NO. 89115 MLJ

12/08/22

DEO ATTACHED


per EON #1164

110726
UNDER REVIEW


Q14213

RELEASED
2009-10-29

B	REVISE GENERAL NOTES/PART LIST; UPDATE TO CURRENT STANDARDS: ADD -147B (ZN C4-2, D4-2)	RF	09.09.30
A	NEW ISSUE	CP	07.07.07
REV	DESCRIPTION	BY	DATE
DESIGN	90	DART AEROSPACE LTD HAWKESBURY, ONTARIO, CANADA	
DRAWN	RF	REV. B	
CHECKED	90	DRAWING NO.	
MFG. APPR.	DS	D212-664-147	SHEET 1 OF 4
APPROVED	100	TITLE	SCALE
DE APPR.	100	CROSSTUBE (205/212/412 LOW FWD)	NTS
DATE	09.09.30	COPYRIGHT © 2007 BY DART AEROSPACE LTD. THIS DOCUMENT IS PRIVATE AND CONFIDENTIAL AND IS SUPPLIED ON THE EXPRESS CONDITION THAT IT IS NOT TO BE USED FOR ANY PURPOSE OTHER THAN COPIED OR COMMUNICATED TO ANY OTHER PERSON WITHOUT WRITTEN PERMISSION FROM DART AEROSPACE LTD.	

 


8 7 6 5 4 3 2 1

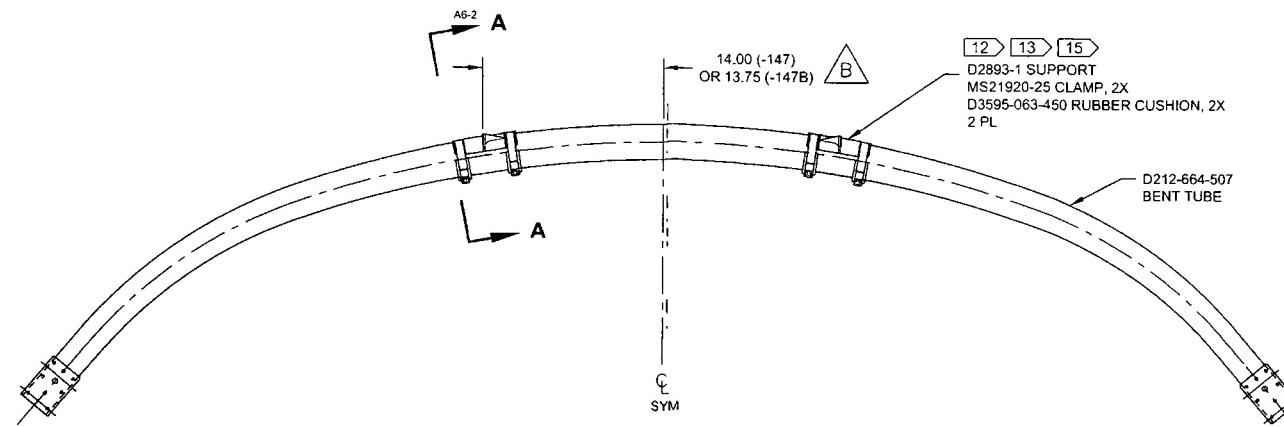

D212-664-147/-147B
ASSEMBLY DETAIL

29/115

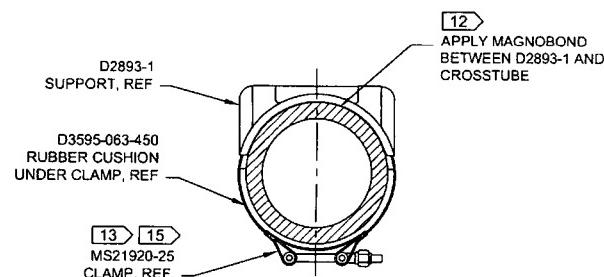



SECTION A-A D5-
SCALE 4X

ECU #11-614
5K.07.20
UNDER REVIEW
~~CP 11.06.13~~

RELEASED
2009-10-29

DESIGN	<i>90</i>	DART AEROSPACE LTD HAWKESBURY, ONTARIO, CANADA		
DRAWN	RF			
CHECKED	<i>90</i>	DRAWING NO.	REV. B	
MFG. APPR.	<i>N</i>	D212-664-147	SHEET 2 OF 4	
APPROVED	<i>MM</i>	TITLE	SCALE	
DE APPR.	<i>MM</i>	CROSSTUBE (205/212/412 LOW FWD)	NTS	
DATE	09.09.30	COPYRIGHT © 2007 BY DART AEROSPACE LTD THIS DOCUMENT IS PRIVATE AND CONFIDENTIAL AND IS SUPPLIED ON THE EXPRESS CONDITION THAT IT IS NOT TO BE USED FOR ANY OTHER PURPOSE OR DISCLOSED TO ANY OTHER PERSON WITHOUT WRITTEN PERMISSION FROM DART AEROSPACE LTD		

 


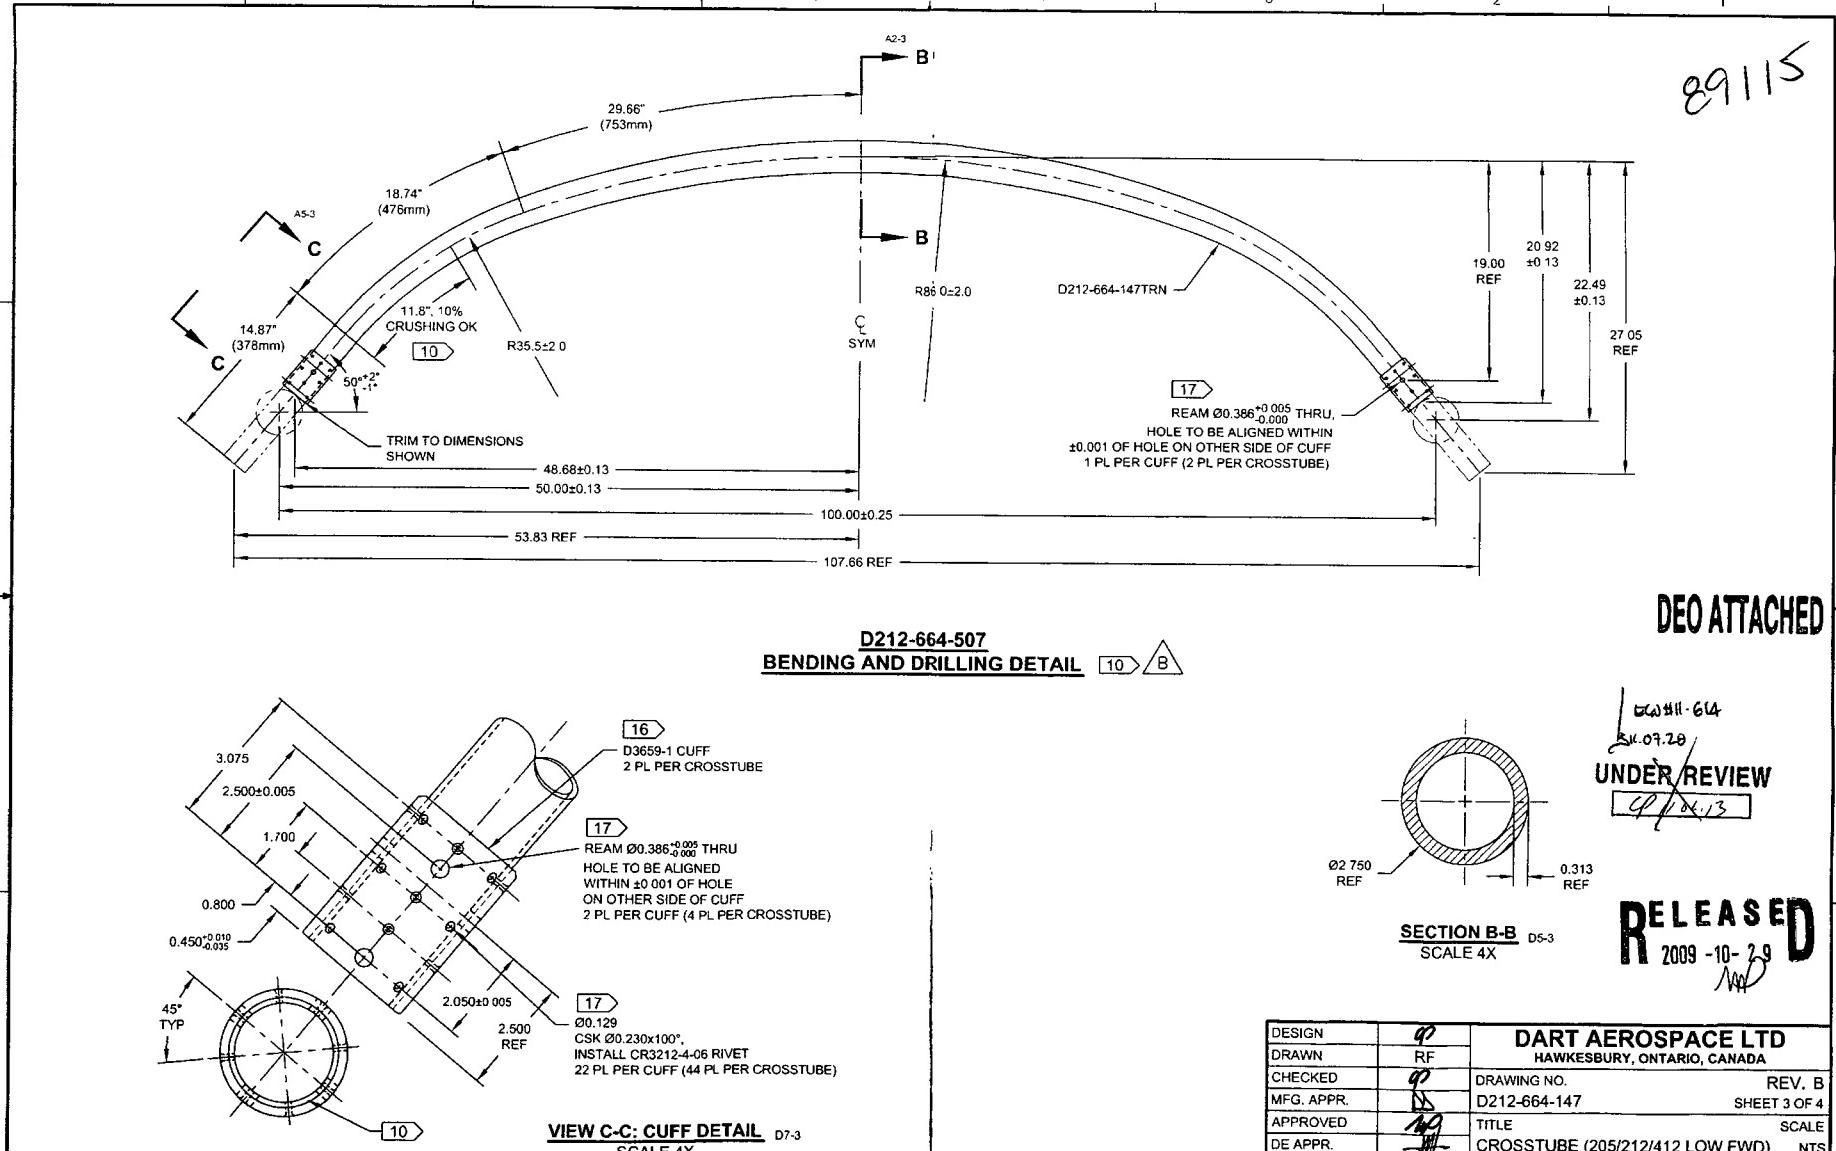


DESIGN	90	DART AEROSPACE LTD
DRAWN	RF	HAWKSLEY, ONTARIO, CANADA
CHECKED	90	DRAWING NO.
MFG. APPR.	90	D212-664-147
APPROVED	90	TITLE
DE APPR.	90	SCALE
DATE	09.09.30	CROSSTUBE (205/212/412 LOW FWD) NTS

REV. B
SHEET 3 OF 4

 COPYRIGHT © 2009 BY DART AEROSPACE LTD.
THIS DOCUMENT IS PRIVATE AND CONFIDENTIAL AND IS SUPPLIED ON THE EXPRESS CONDITION THAT IT IS
NOT TO BE USED FOR ANY PURPOSE OR COPIED OR COMMUNICATED TO ANY OTHER PERSON WITHOUT
WRITTEN PERMISSION FROM DART AEROSPACE LTD.




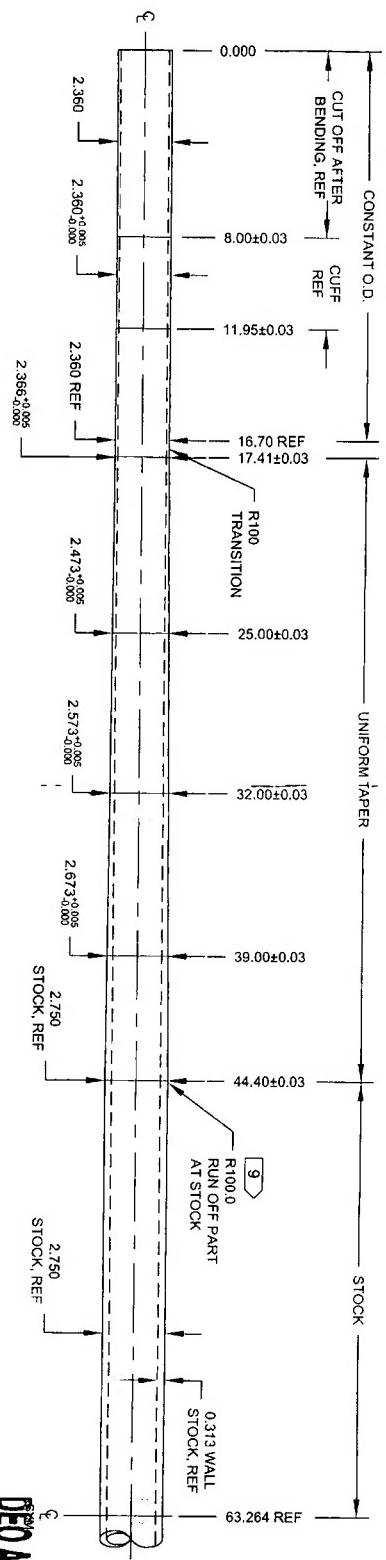

~~UNDER REVIEW~~

DETACHED

 RELEASED
2009-10-29



DRAWING NO. D212-664-147	TITLE CROSSTUBE ASS'Y (205 LOW FWD)	REV. B	DART AEROSPACE LTD ENGINEERING ORDER	D.E.O. NO. D212-664-147-B-1	SHEET NO. SHEET 1 OF 1	SCALE NTS
DRAWN <i>q</i>	CHECKED <i>AS</i>	MFG. APPR. <i>PS</i>	APPROVED <i>JW</i>	DE APPR. <i>H</i>		
DATE 11.07.15	DATE 11.07.20	DATE 11.07.21	DATE 11.07.21	DATE 11.07.21	DATE 11.07.21	

PURPOSE:

REPLACE MAGNOBOND WITH PROSEAL.

09115

CHANGE:

IS:

Item	Qty -147	Qty -147B	Part Number	Description
9	A/R	A/R	PROSEAL 890 B-2	SEALANT, AMS-S-8802 CLASS B-2

WAS:

9	A/R	A/R	MAGNOBOND 6398	ROCKWELL SPECIFICATION RBO-120-023 ADHESIVE (TEXTRON/BELL SPEC. 299-947-100, TYPE II, CLASS 2 ADHESIVE)
---	-----	-----	----------------	---

NOTE 12 & 15, SHEET 1 IS AMENDED AS FOLLOWS:

IS:

- 12) TO INSTALL D2893-1 SUPPORT: ABRADE MATING SURFACE OF SUPPORT AND CROSSTUBE WITH 180-GRT SANDPAPER AND REMOVE RESIDUE WITH MEK (OR EQUIVALENT). APPLY A 0.04" TO 0.07" THICK LAYER OF PROSEAL 890 CLASS B-2 (OR AMS-S-8802 CLASS B-2) SEALANT TO MATING SURFACE OF SUPPORT.
- 15) TORQUE CLAMPS 80 TO 100 IN-LB. ENSURE AT LEAST 1.5 THREADS SHOWING IN SAFETY AND THAT NUT HAS NOT BOTTOMED-OUT AFTER TORQUING. PRIOR TO PACKAGING, RE-CHECK TORQUE ON CLAMPS AFTER PROSEAL 890 SEALANT HAS CURED FOR 72 HOURS.

WAS:

- 12) INSTALL D2893-1 SUPPORT USING 0.03" TO 0.06" THICK LAYER OF MAGNOBOND 6398 TO THE SURFACE OF D2893-1 THAT WILL BE IN CONTACT WITH THE CROSSTUBE PER QSI 015. LET CURE FOR 12 HOURS AFTER INSTALLATION AND PRIOR TO PACKAGING.
- 15) TORQUE CLAMPS 80 TO 100 IN-LB. ENSURE AT LEAST 1.5 THREADS SHOWING IN SAFETY AND THAT NUT HAS NOT BOTTOMED-OUT AFTER TORQUING.

RELEASED
2011-07-28
WJW

